

**SITE PLAN**

PAINESVILLE TWP., LAKE COUNTY, OHIO

for: MATOUSEK

CLIENT \_\_\_\_\_ OWNER \_\_\_\_\_  
ADDRESS \_\_\_\_\_ STREET \_\_\_\_\_ CITY \_\_\_\_\_ ZIP \_\_\_\_\_

SUBDIVISION NAME TRACT \_\_\_\_\_ STREET \_\_\_\_\_  
VOL-PG. 188 LOT \_\_\_\_\_  
1 SUBLOT NO. NORTH DOAN STREET VOL-PG. PERM. PARCEL NO. \_\_\_\_\_

**LEGEND**

SANITARY MANHOLE --- ○ ---  
STORM MANHOLE --- ● ---  
INLET OR CATCH BASIN --- □ ---  
HYDRANT --- ⊕ ---  
EXISTING CONTOURS --- - - - -  
PROPOSED CONTOURS --- ————

EDGST. ELEV. --- 100.0  
100.0 = 2' PROP. ELEV.

AS BUILT ELEVATION  
INDICATES DIRECTION OF SURFACE DRAINAGE

**REMARKS**

ALL BOUNDARY DATA SHOWN WAS OBTAINED FROM (DEEDS, RECORDED SUBDIVISION PLAT OR OTHER PUBLIC RECORDS)  
LOCATIONS AS SHOWN OF ADJACENT WELLS AND SEPTIC TANKS OBTAINED FROM LAKE COUNTY HEALTH DEPARTMENT

**DESIGN CERTIFICATION**

THIS PLAT WAS PREPARED BY ME, AND IS CORRECT TO THE BEST OF MY KNOWLEDGE AND BELIEF.

NAME Harry S. Jones, Jr. SURVEYOR REGISTRATION NO. 8-6343

**CHECK LIST**

NO. OF BEDROOMS	WATER MAIN SIZE, LOCATION
DIMENSIONS	SAN. SEWER SIZE & OR. LOC.
BEARINGS	SAN. MH. CAST. ELEV. INV. ELEV.
TIE TO NEAREST STREET	SAN. CONN. SIZE, LOC. DEPTH
SUBLOT NO. PARCEL NO.	STORM SEWER SIZE & OR. LOC.
SURROUNDING OWNERS	STORM MH. CAST ELEV. INV. ELEV.
BLDG. DIMENSIONS FIN GR.	PAVT TYPE GRADE CURBS
BLDG. TIES FLR. GRADES	GAS LINE LOC. SIZE PRESSURE
APRON TYPE WIDTH THICKNESS	SEPTIC TANK LOCATION & DUPLICATION AREA
SIDEWALK TYPE WIDTH THICKNESS	WELL LOCATION
CULVERT TYPE DIA., LENGTH	ISOLATION RADIUS FROM WELL
ROCK OUTCROPPINGS	

REVISIONS			PLAN PREPARED BY:	
NO.	DATE	BY	BABCOCK JONES & ASSOCIATES, INC.	
1	7/6/00	CH	PAINESVILLE, OHIO	
2			DRAWN BY A.H.	SCALE 1"=20'
3			CHK'D. H.J.	DATE 7/9/99
4			CREW CHIEF K.J.	APP'D H.J.
5			PHONE NO. 440-357-1811	DRAWING NO. 98-004-01


**"AS BUILT" CERTIFICATION**  
I, HEREBY CERTIFY THAT THE CIRCLED GRADES ARE EXISTING FINISH GRADES CHECKED IN THE FIELD ON \_\_\_\_\_, 19\_\_\_\_ AND ARE CORRECT TO THE BEST OF MY KNOWLEDGE AND BELIEF.

REGISTERED SURVEYOR \_\_\_\_\_ REG. NO. \_\_\_\_\_

CURVE 1: R=482.63' L=1.35' C=1.35' D=00°09'39" N61°32'20"W  
CURVE 2: R=612.00' L=48.70' C=48.69' D=04°33'35" N59°31'25"W

TBM - san. mh. #4  
rim 659.06  
inv. 653.78

APPROVED  
PAINESVILLE TOWNSHIP  
ZONING DEPARTMENT  
2000-9-57  
D. J. [Signature]

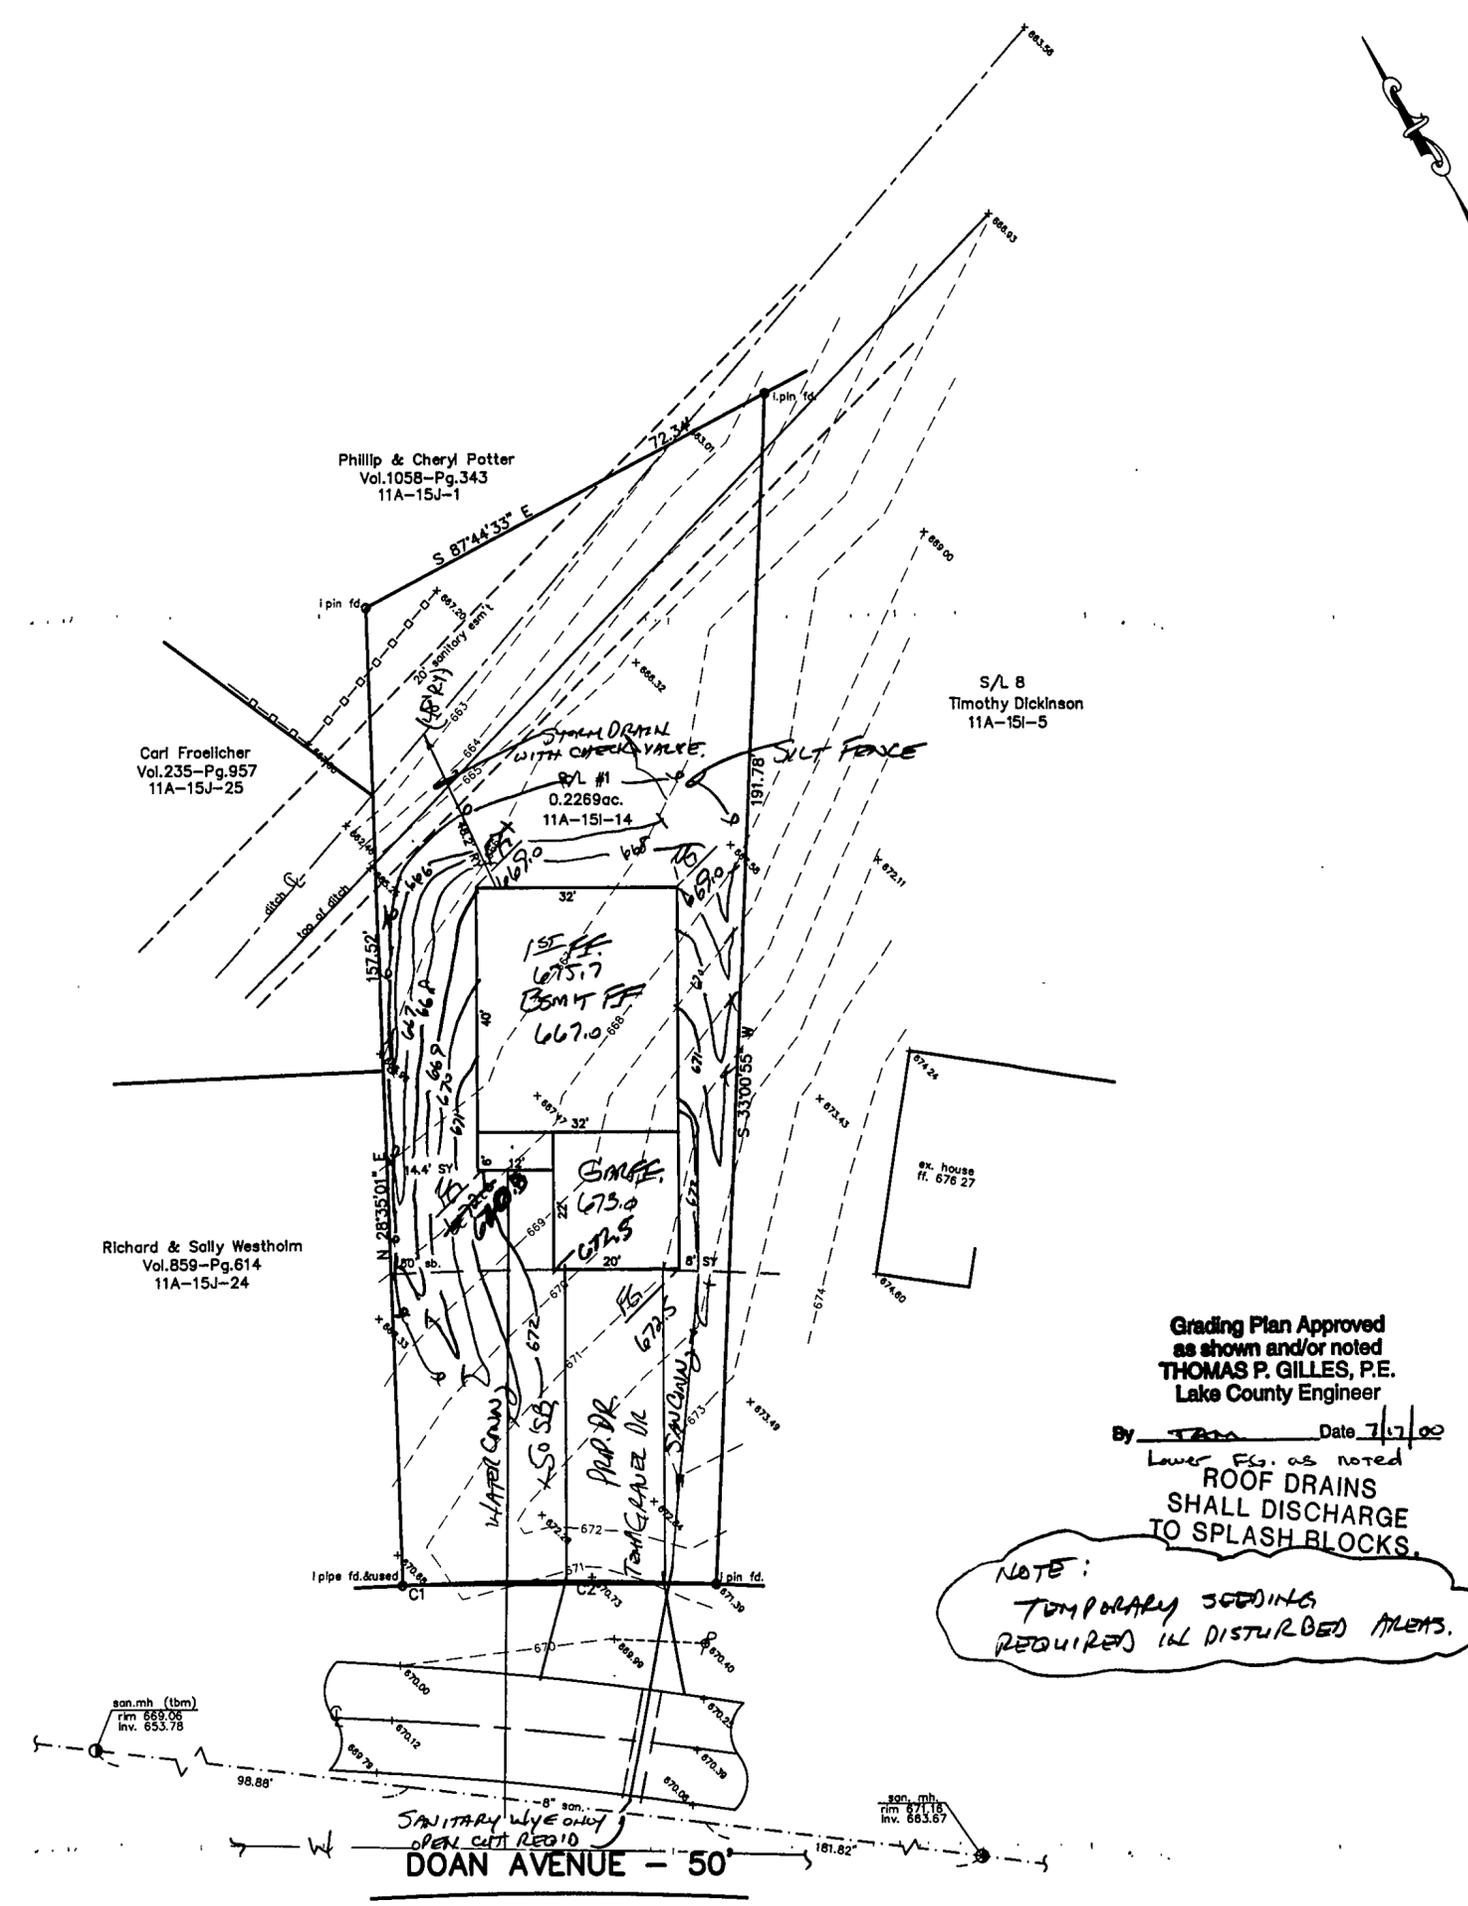

Grading Plan Approved as shown and/or noted  
**THOMAS P. GILLES, P.E.**  
Lake County Engineer

By TBM Date 7/17/00  
Lower Fg. as noted  
ROOF DRAINS SHALL DISCHARGE TO SPLASH BLOCKS.

NOTE:  
TEMPORARY SEEDINGS REQUIRED IN DISTURBED AREAS.

DOAN AVENUE - 50'